





Front Elevation



Rear Elevation

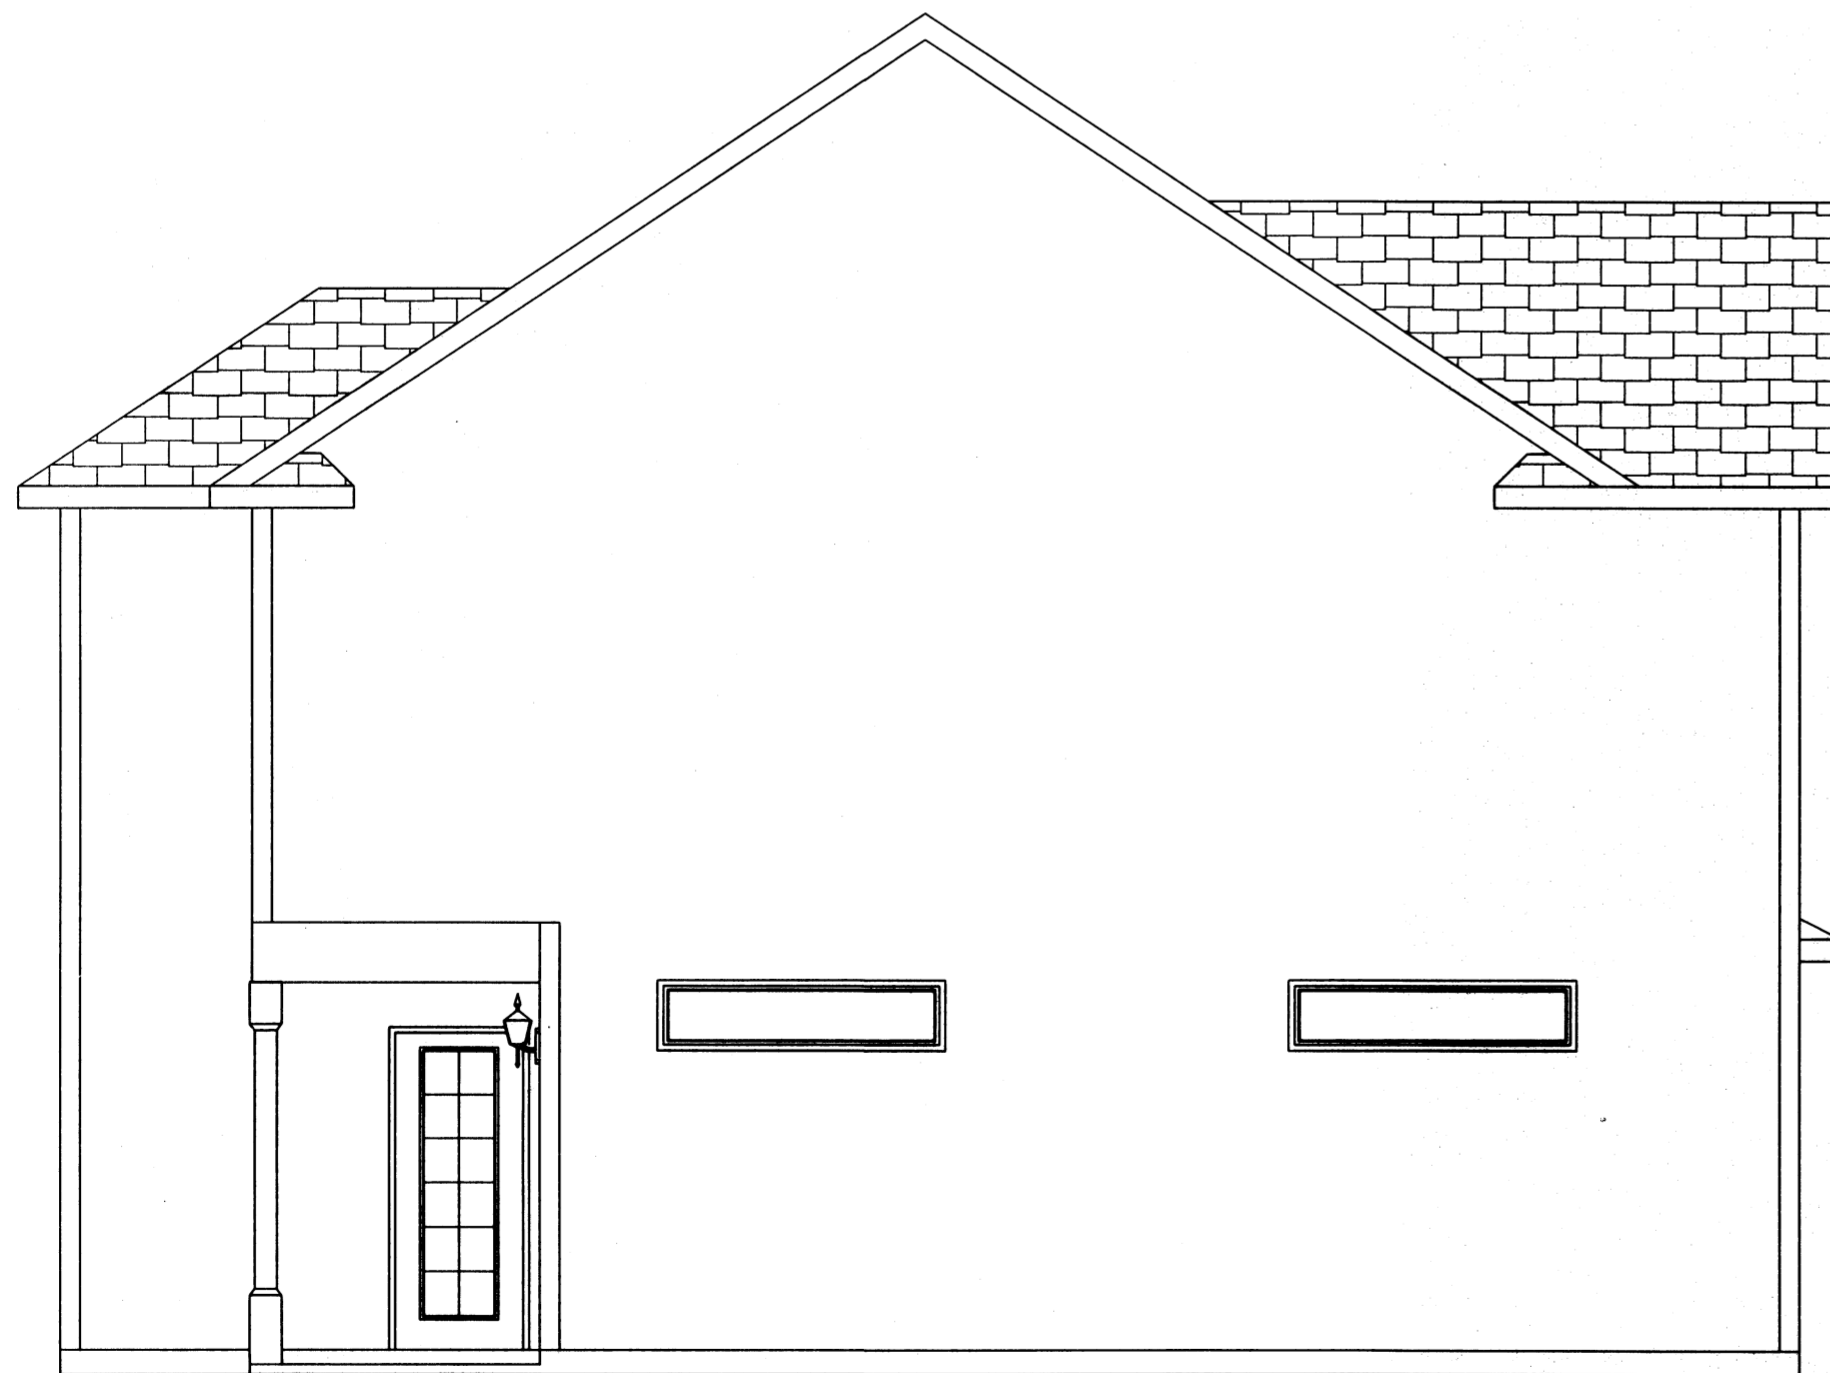

Left Elevation

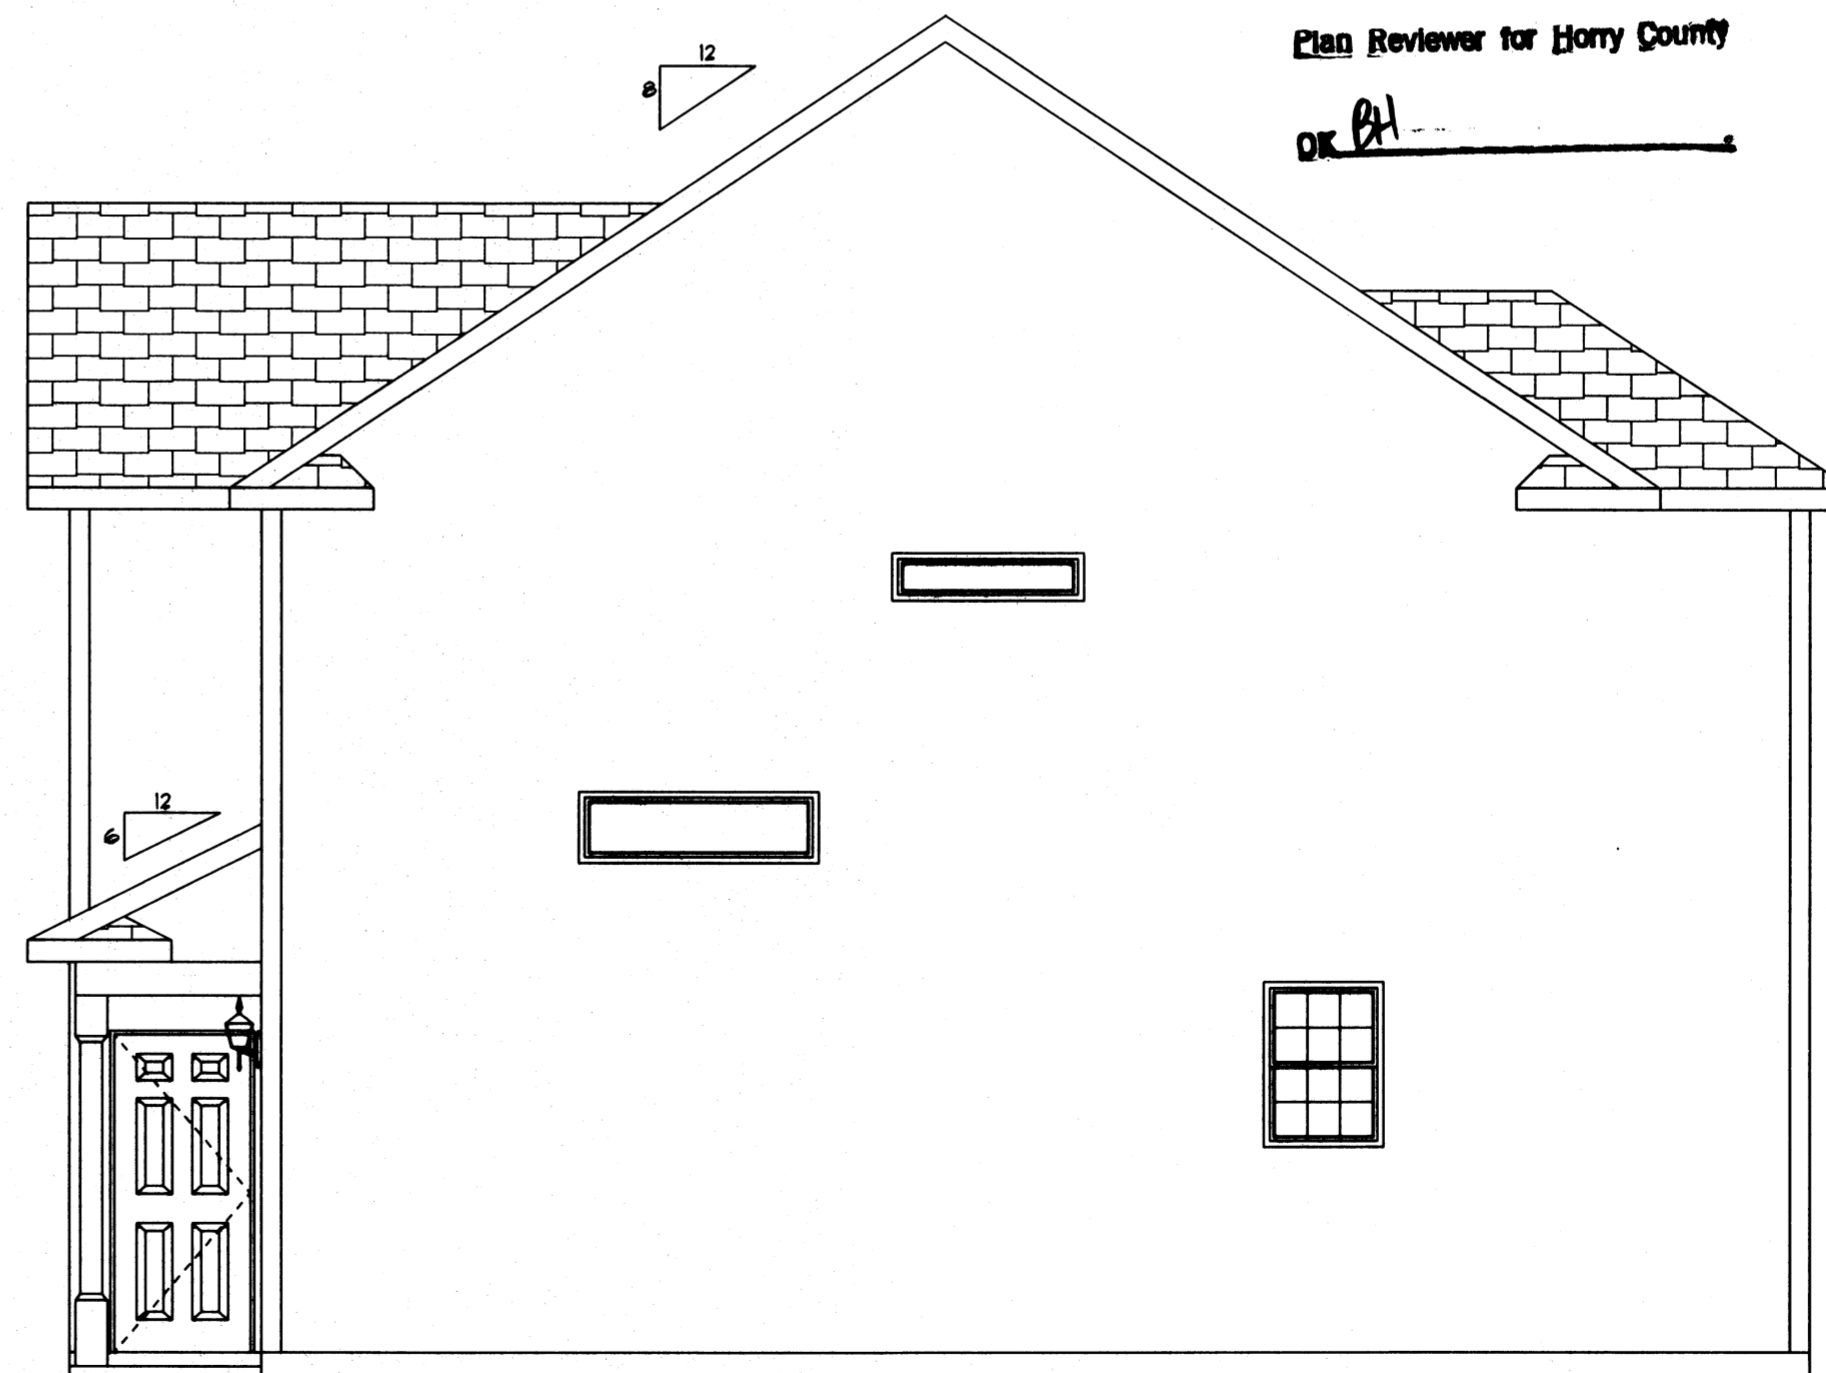

Right Elevation

Plan Reviewer for Horry County

OK *PH*

Header Hgt Notes
 Windows and Doors set
 at standard header height

Scale:
 1/4" = 1'

(843) 294-2859

Villas at The Gates
 Dawol Homes

Villa 6
 Myrtle Beach, SC

AI