


**Header Hgt Notes**

Windows and Doors set at standard header height (except as noted)

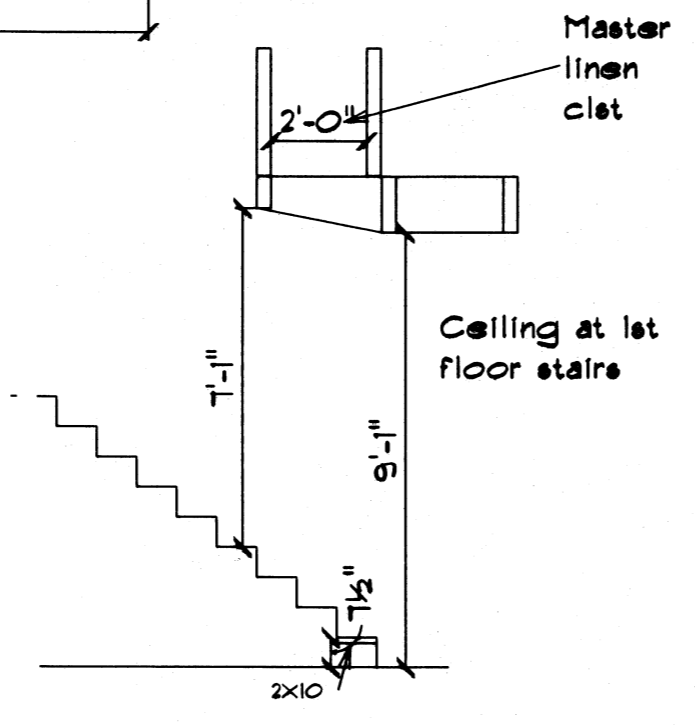

**Scale:**  
1/4" = 1'

**Square Footage**

1st Floor Heated	703
2nd Fir Heated	781
Total Heated	1,484
Porches	134
Storage	43
Total Under Roof	1,661

Plan Reviewer for **Horry County**  
OK BH

(843) 294-2859

Villas at The Gates  
Dawol Homes

Villa 6  
Myrtle Beach, SC

A2